

# Marshall Elementary Rooftop Package Unit Replacement (9) Project- Bid # 24.065

## Questions and Answers

1. Are there drawings for the "Rooftop Package Unit Replacement (9) at Marshall Elementary # 24.065?


**Answer:** We have As-Builts for the existing equipment only. See Page 3,4,5,6

2. We have had some contractors reach out for the upcoming Marshall & King replacement RTU job and wanted to confirm if they district would approve Tran Rooftop units if we required curb adapters?

**Answer:** Yes

3. When did you want the work to be done?

**Answer:** Depending on how long the equipment takes to be delivered. We would like the work completed during our Fall break, Oct 7<sup>th</sup> through October 11<sup>th</sup>, 2024.

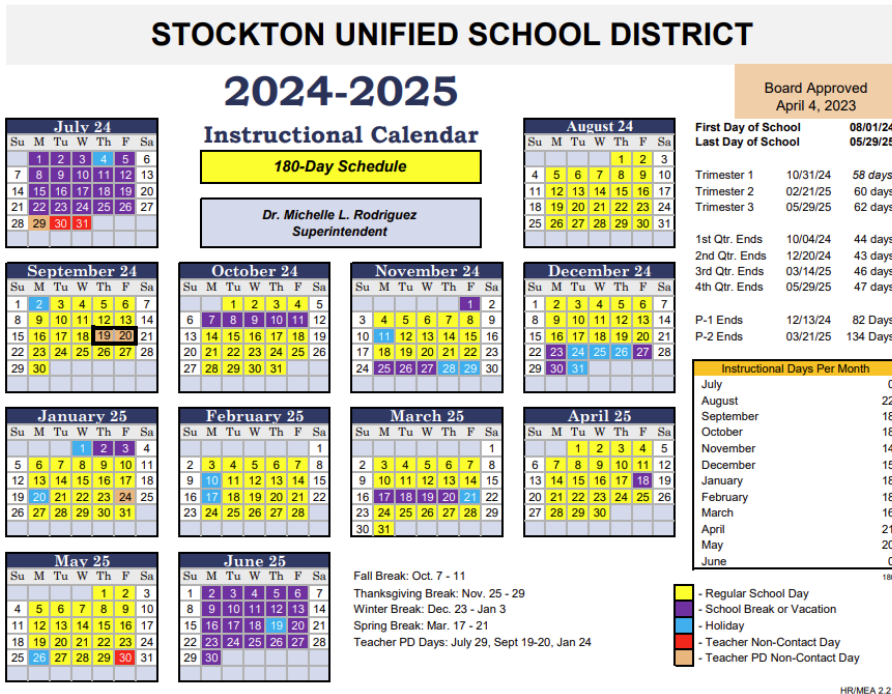

4. When you open the Marshall Specifications document it says that its for King Elementary and it has a different Project number on it, is this the correct specifications for the job?

**Answer:** The Specifications for Stockton Unified School District are for Mechanical General Provisions and remain the same from project to project. The description should have been left off.

5. Where do you want the point of connection to be on the ductwork?

**Answer:** From the unit to the penetration.

6. Do you want all the PVC condensate drain replaced or do you want us to connect to the existing PC piping?

Answer: Connect to existing PVC.

7. Do you want new disconnect SW's?

Answer: Yes. Rated Heavy-Duty

8. Do you want new equipment pad covers?

Answer: Curbs and curb caps

9. Do you want Title 24 economizers?

Answer: Yes

10. Do you want all the existing ductwork and grills pressure tested and cleaned?

Answer: Yes

11. Do you want all the classroom's air balanced?

Answer: Yes

12. Are the existing controls to be disconnected and reconnected to the new units?

Answer: Disconnect only, we will reconnect in-house.

13. Do you want the economizers added to the existing controls and the controls Graphix update?


Answer: No

14. Is an ASSC factory certified technician acceptable for the start-up of the equipment?

Answer: Yes


15. Do you require Title 24 commissioning?

Answer: Yes

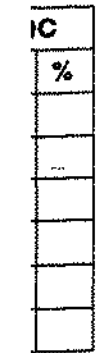


946 North Yosemite Street  
 Stockton, California 95203-2217  
 P. (209) 462 2873  
 F. (209) 462 2308  
 E. dca@dcaia.com  
 W. http://www.dcaia.com

**Marshall Middle  
 School Modernization**  
 Stockton Unified School  
 District  
 Stockton, California

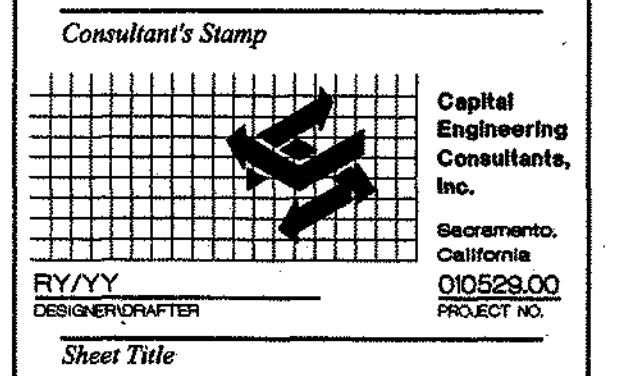


**HVAC  
 Floor Plan**

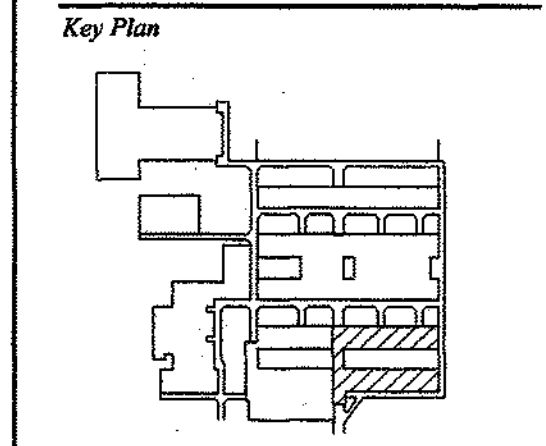

IDENTIFICATION STAMP  
 DIV. OF THE STATE ARCHITECT  
 02 104030  
 AC FL: BH SS 27  
 DATE

Job Number  
**00.445**  
 Drawn By  
 Date  
**December 31, 01**  
 Sheet Number  
**M2.2**  
 Total Sheets  
 of  
 Revisions  
 DSA Number  
 Architect's Stamp

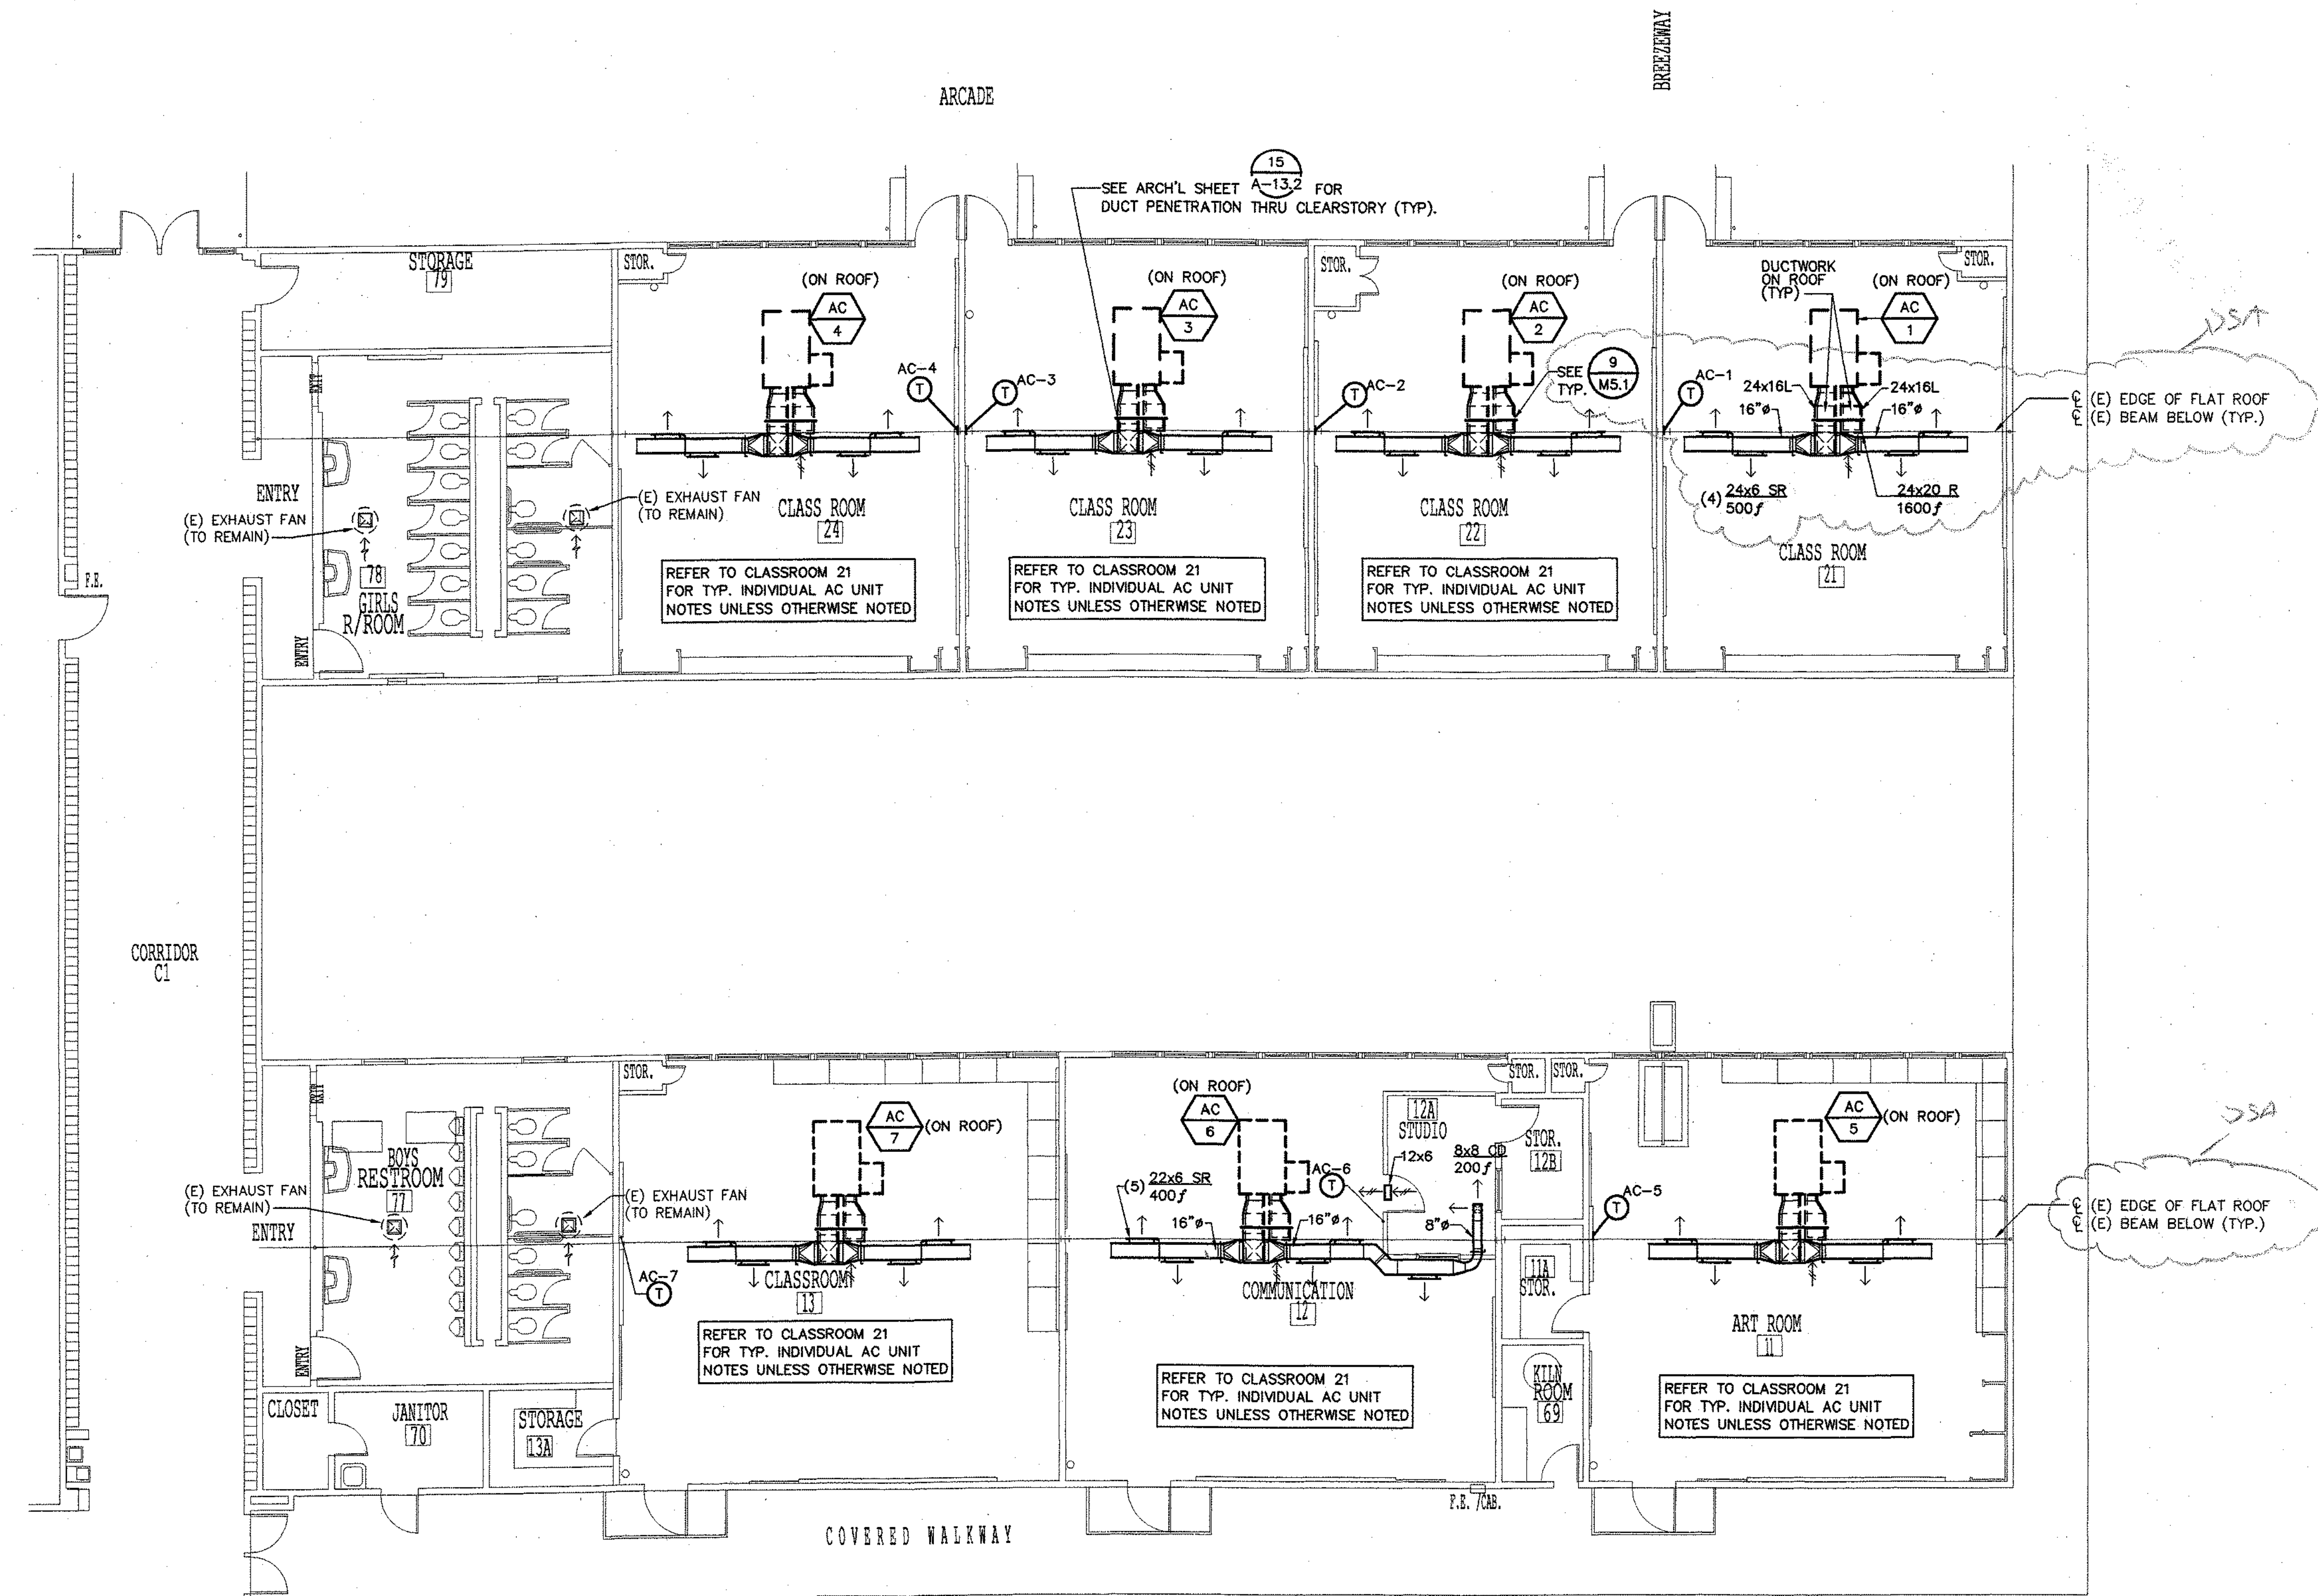

- GENERAL NOTES:**
1. CONTRACTOR SHALL VERIFY LOCATION FOR ALL (E) MECHANICAL, PLUMBING, ELECTRICAL & STRUCTURAL PRIOR TO CONSTRUCTION.
  2. ALL OUTSIDE AIR HOODS FROM AC UNITS SHALL MAINTAIN A MINIMUM OF 10'-0" CLEAR FROM ALL FLUES, COMBUSTION AIR OPENINGS, EXHAUST & PLUMBING VENTS.
  3. PROVIDE LOCKING COVERS OVER ALL THERMOSTATS.


**HVAC PLAN - SECTION I**

SCALE : 1/8" = 1'-0"

**1  
 M2.2**



52802

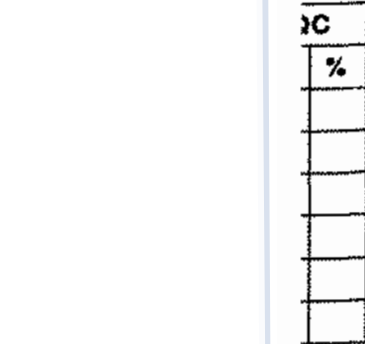


DCA

DESIGN  
CONSTRUCTION  
ARCHITECTURE

949 North Yosemite Street  
Stockton, California 95205-2217  
P. (209) 462-2073  
F. (209) 462-6300  
E. dca@dcacal.com  
W. http://www.dcacal.com

**Marshall Middle  
School Modernization**  
Stockton Unified School  
District  
Stockton, California



Consultant's Stamp

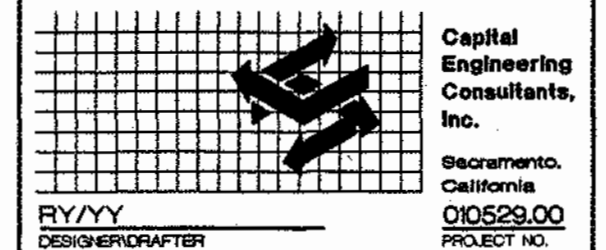

Sheet Title

**HVAC  
Demolition Plan**

Key Plan

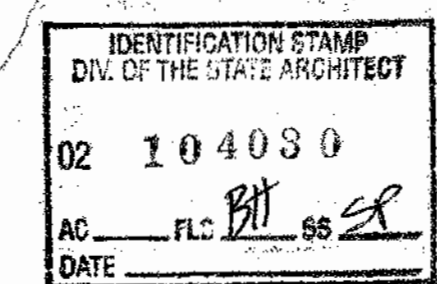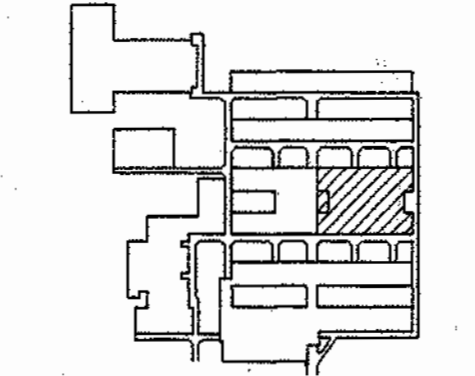

Job Number

00.445

Drawn By

Date

December 31, 01

Sheet Number

**M2.3**


Total Sheets

of

Revisions

DSA Number

Architect's Stamp

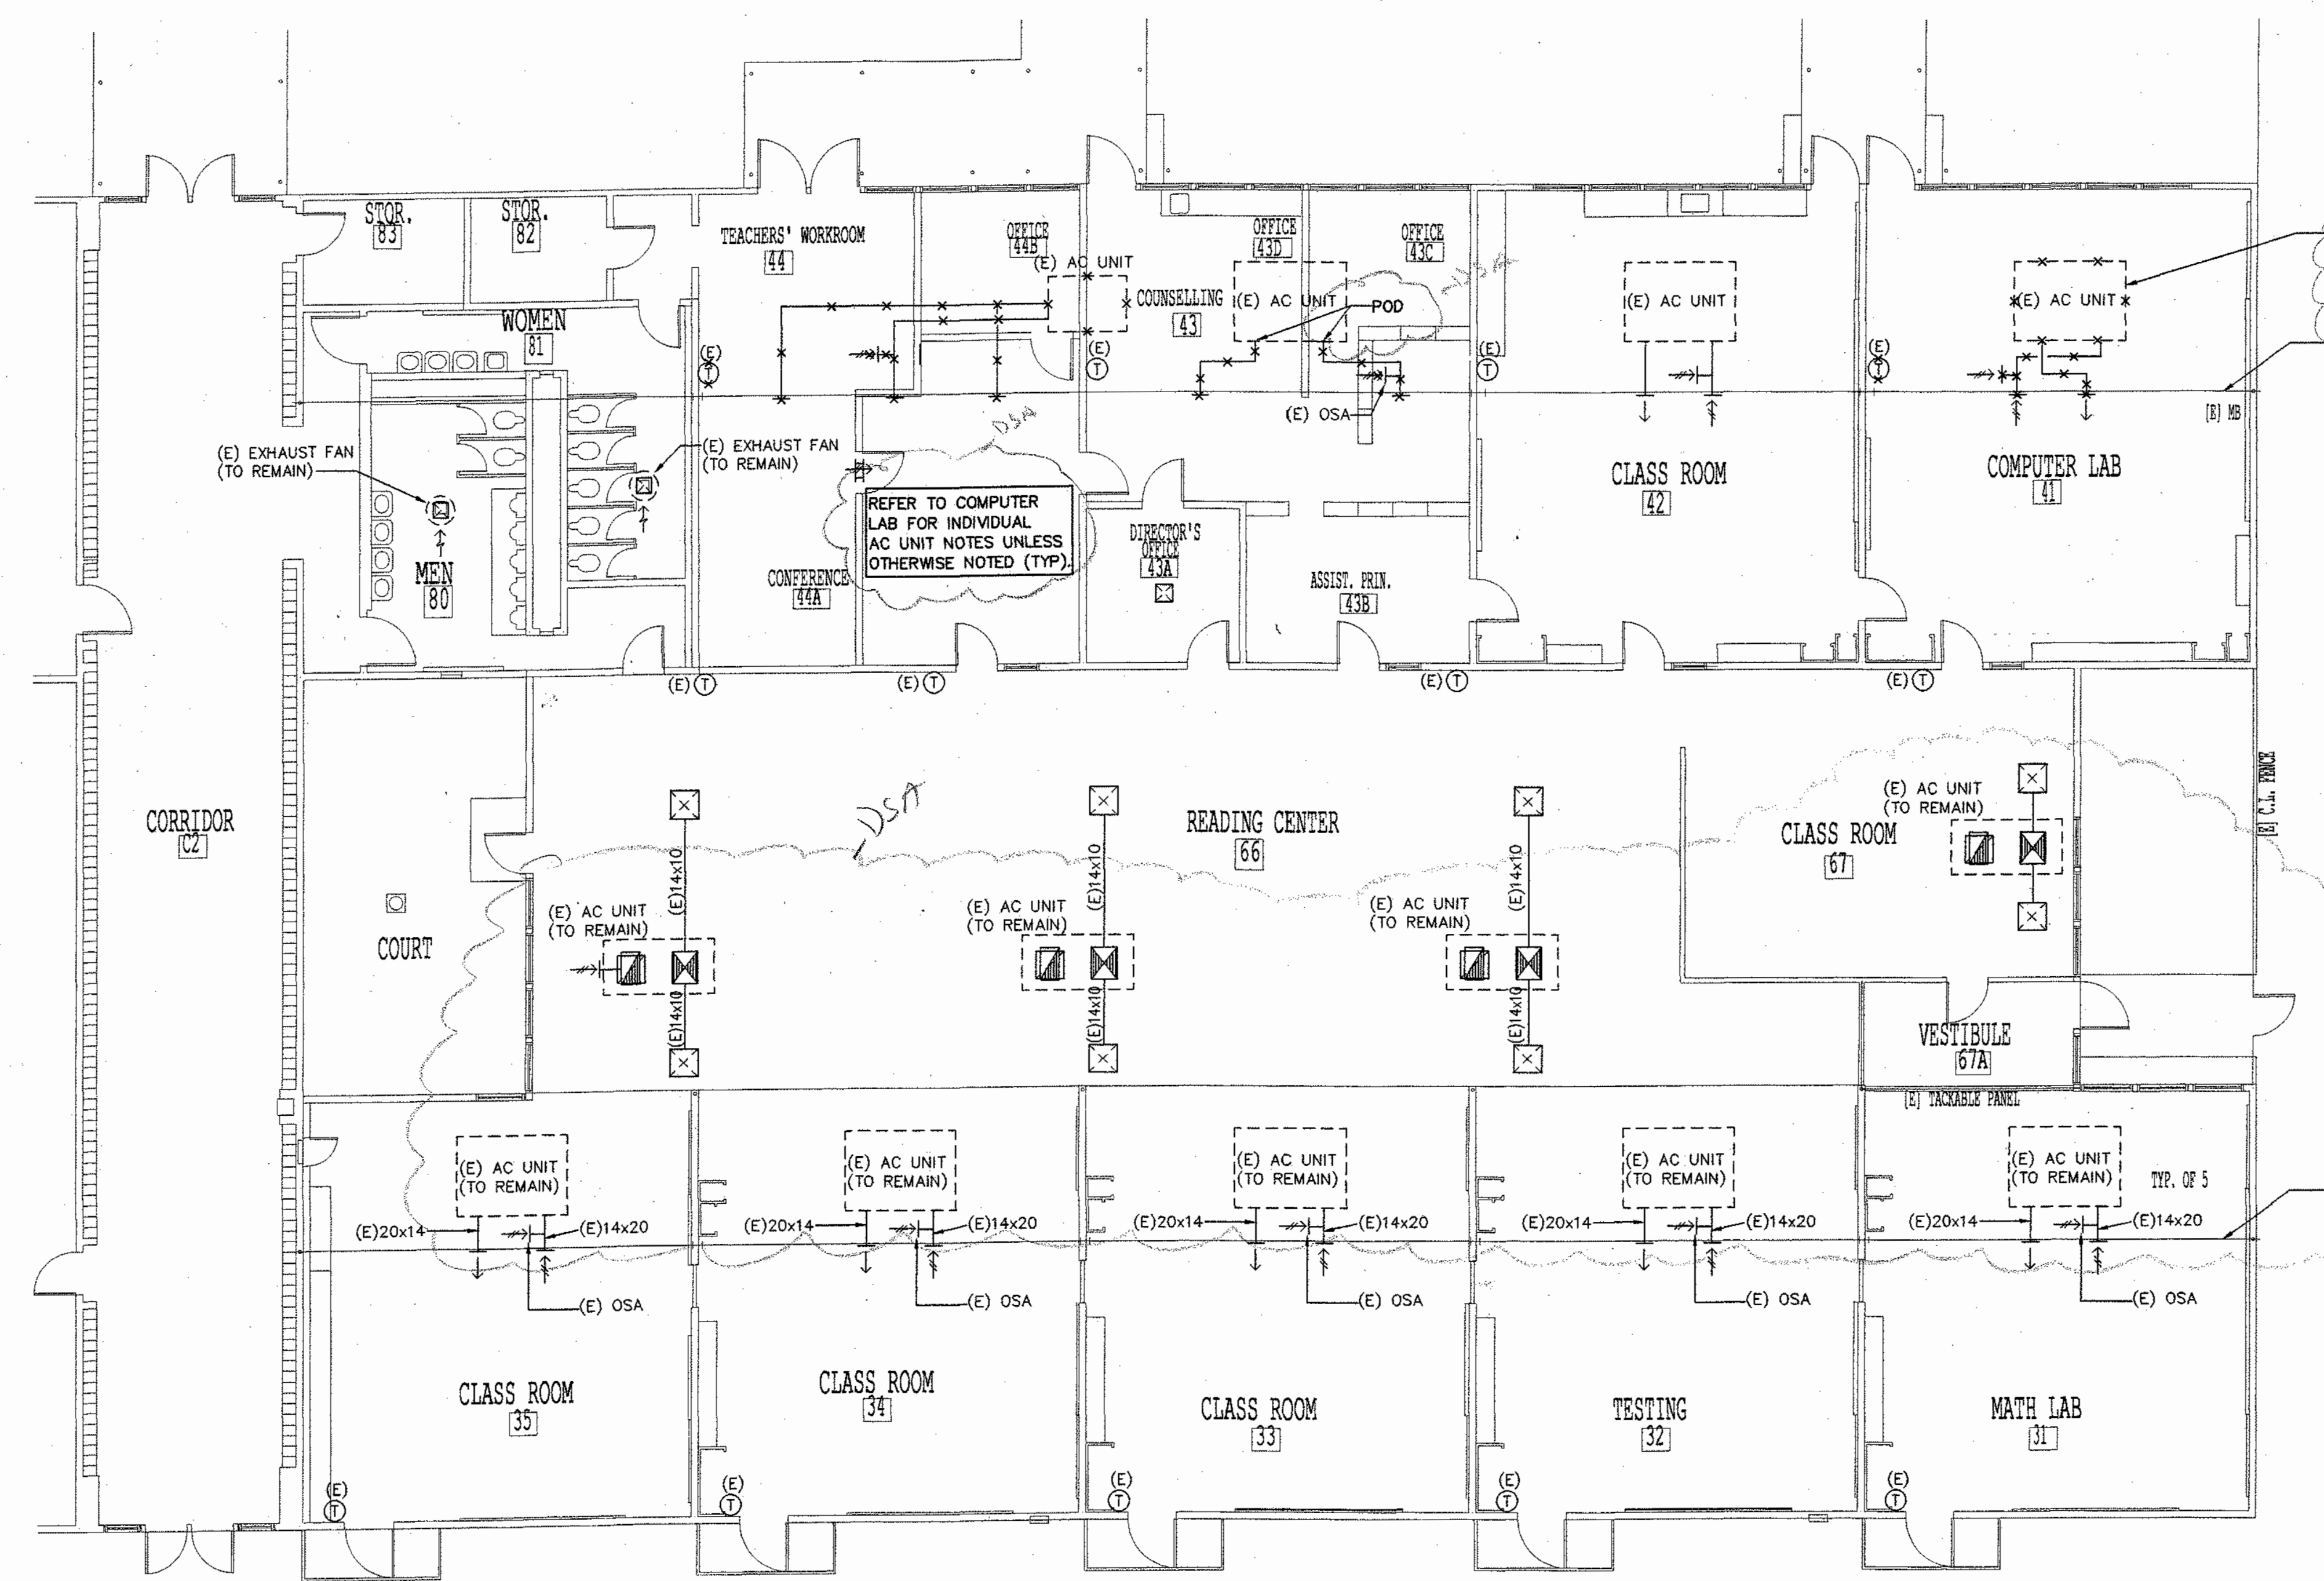



REMOVE (E) AC UNIT, CURB, DUCTWORK,  
DISCONNECT (E) GAS & CAP, REMOVE SOV,  
UNION, DIRTLEG & GRILLE  
EDGE OF FLAT ROOF &  
E (E) BEAM BELOW (TYP.)

REFER TO COMPUTER  
LAB FOR INDIVIDUAL  
AC UNIT NOTES UNLESS  
OTHERWISE NOTED (TYP.)


EDGE OF FLAT ROOF &  
E (E) BEAM BELOW (TYP.)

- GENERAL NOTES:**
1. CONTRACTOR SHALL RETURN (E) AC UNITS BACK TO SCHOOL DISTRICT IF STILL IN GOOD RUNNING CONDITION.
  2. CONTRACTOR SHALL VERIFY LOCATION FOR ALL (E) MECHANICAL, PLUMBING, ELECTRICAL & STRUCTURAL PRIOR TO CONSTRUCTION.
  3. REPLACE (E) BELTS, FILTERS AND CLEAN INSIDE (E) AC UNITS.

**HVAC DEMOLITION PLAN - SECTION II** 1 M2.3  
SCALE : 1/8" = 1'-0"

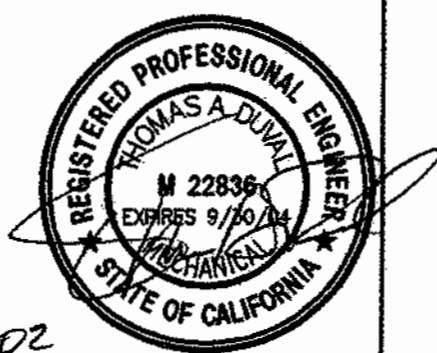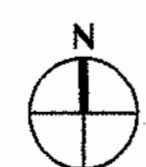

5-28-02

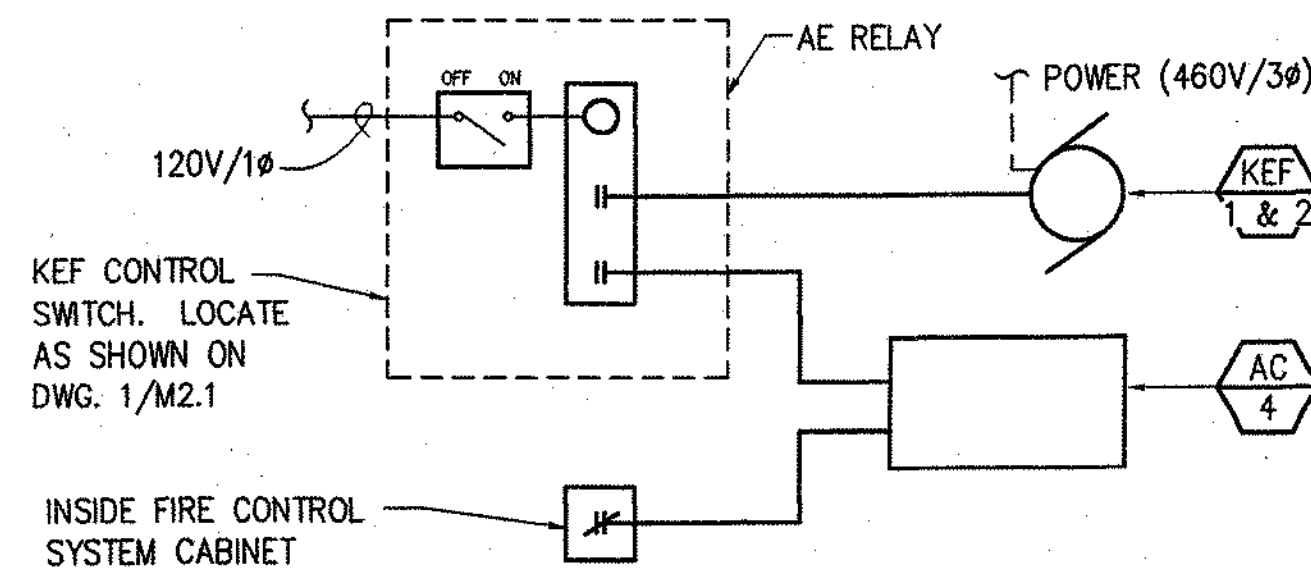


**DESCRIPTION OF OPERATION**

THE KITCHEN EXHAUST FAN WILL BE MANUALLY OPERATED BY AN ON/OFF SWITCH, AND WILL BE INTERLOCKED WITH AC-4 SUCH THAT WHEN KEF-1 & 2 IS ENERGIZED, THE SUPPLY FAN OF AC-4 SHALL OPERATE SIMULTANEOUSLY. MECHANICAL COOLING/HEATING WILL BE ALLOWED TO OPERATE TO MAINTAIN SPACE SET POINT. WHEN KEF-1 & 2 IS NOT ENERGIZED AC-4 WILL FUNCTION NORMALLY.

**KEF-1 & 2 CONTROL DIAGRAM**

SCALE : NONE


**7**  
M5.1

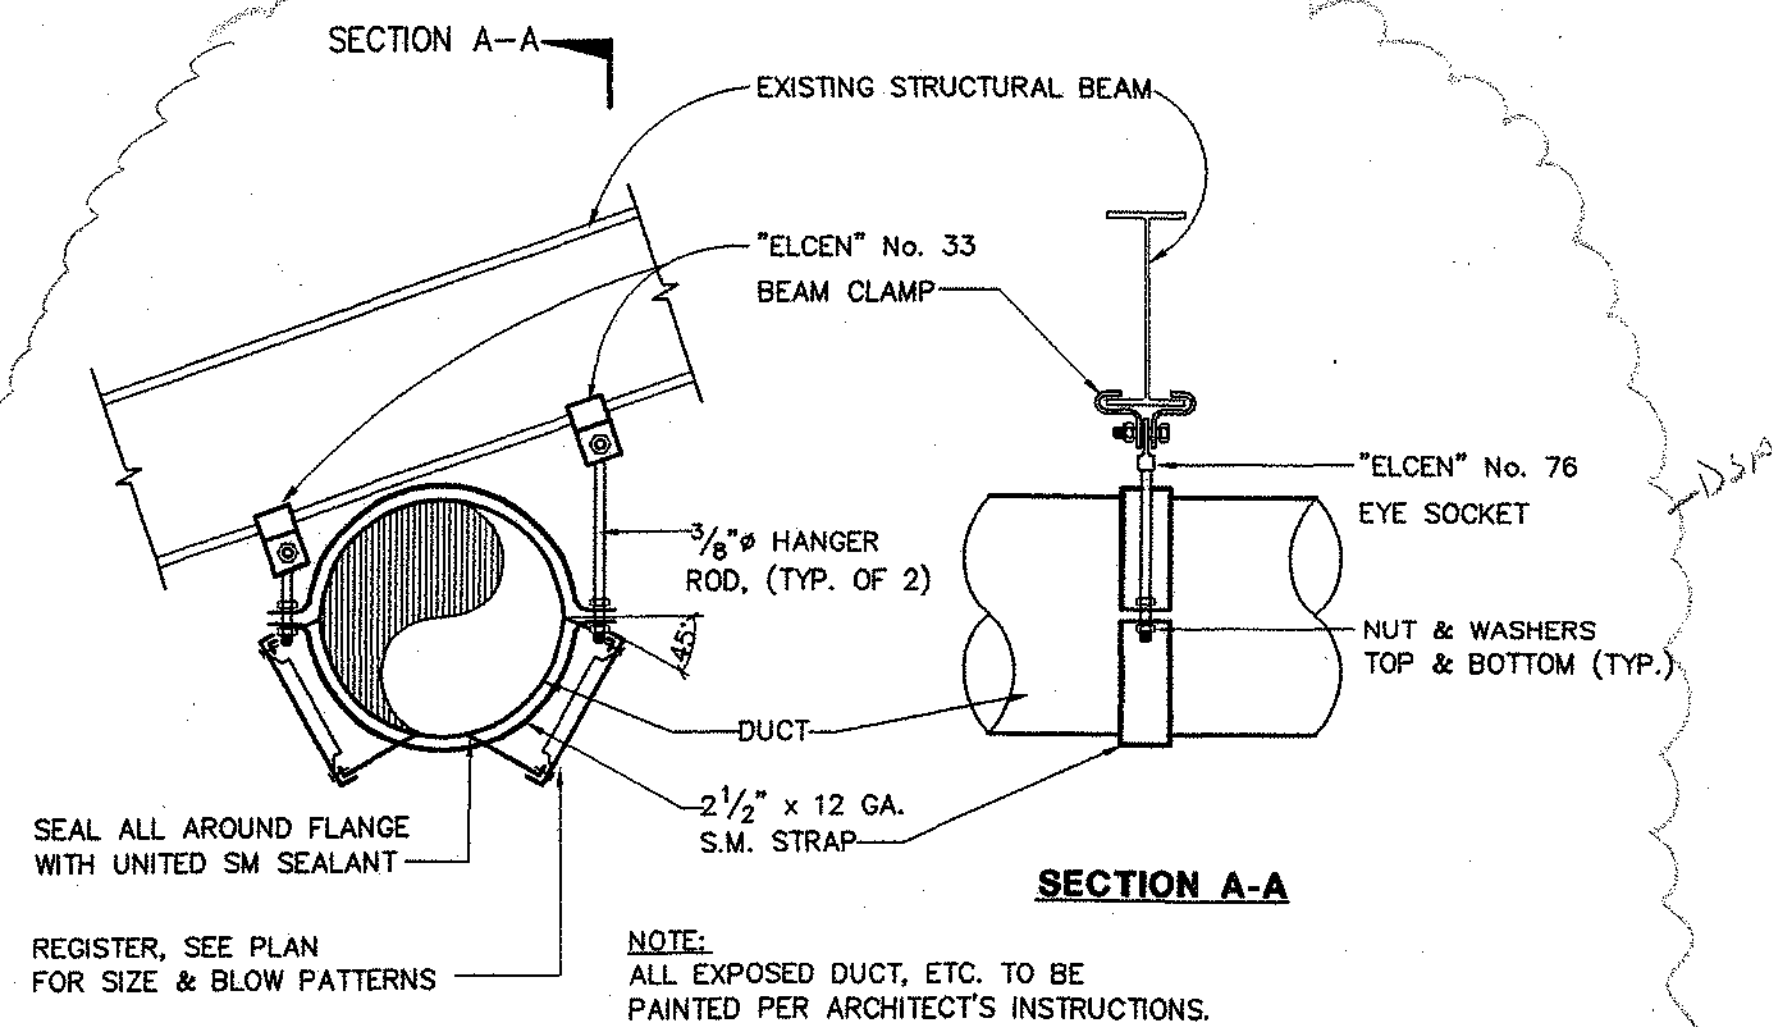

**DIFFUSER @ EXPOSED DUCT - AT GYM**

SCALE : NONE


**4**  
M5.1

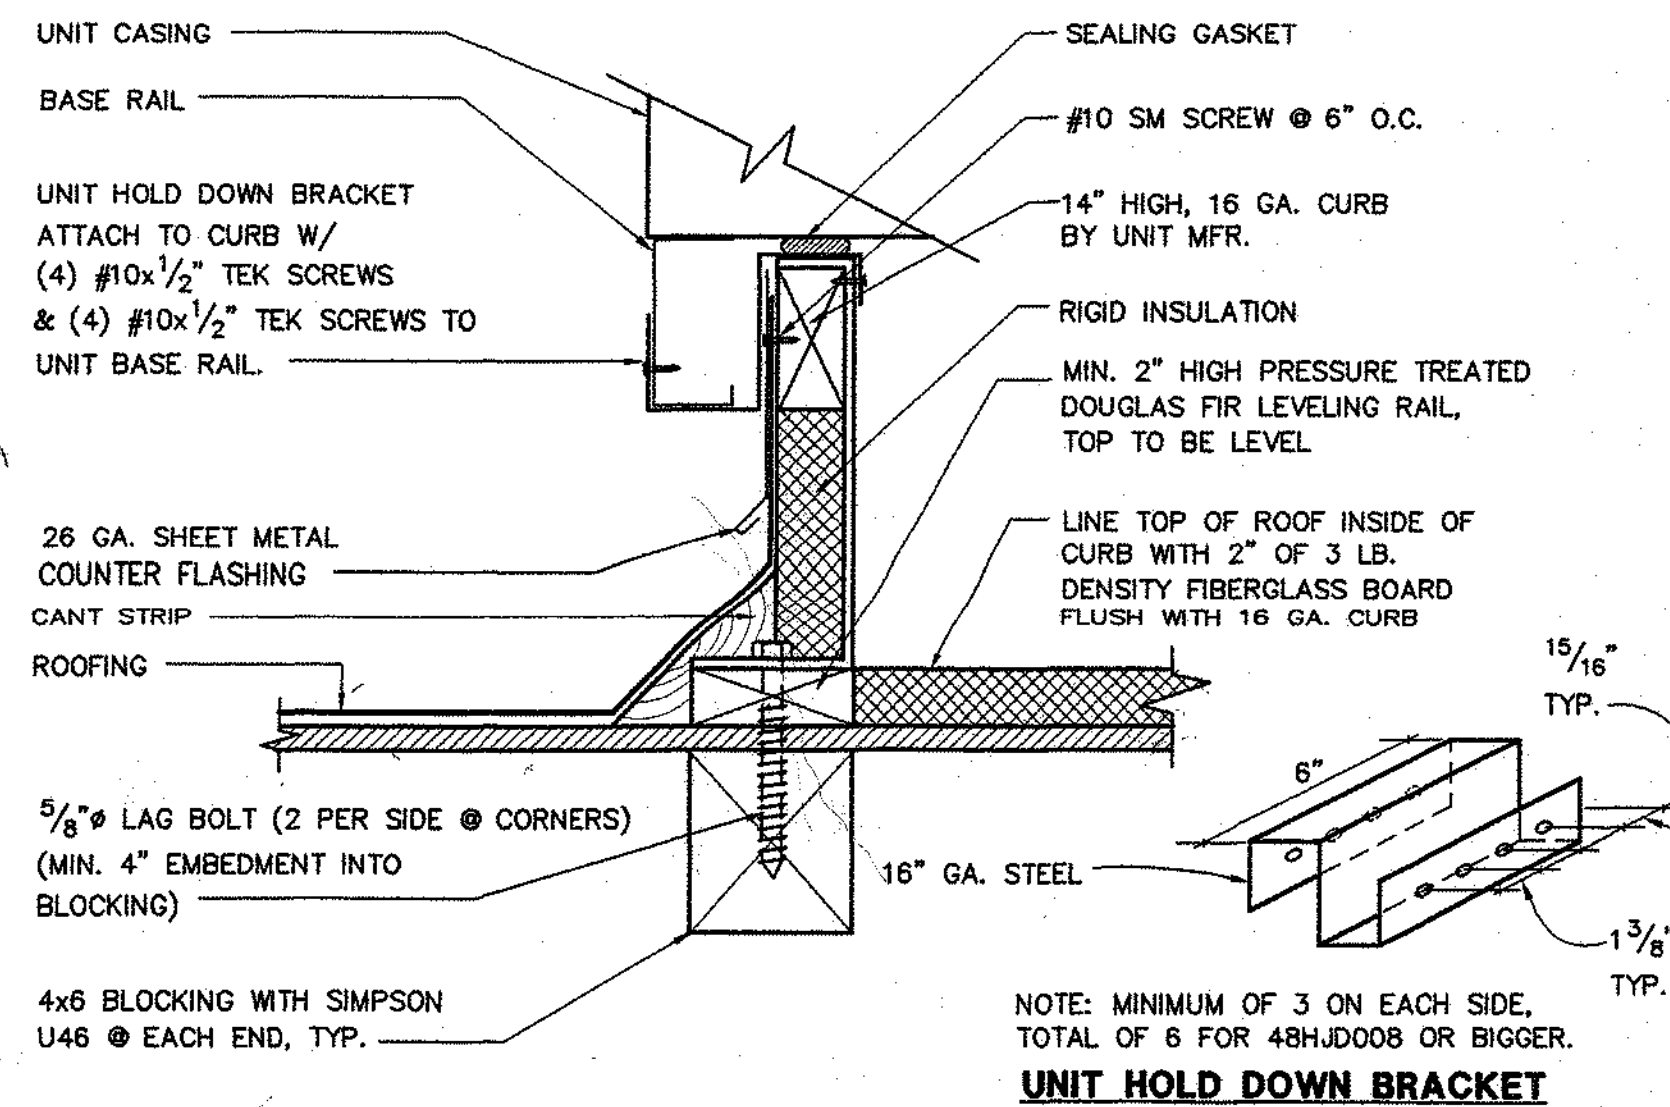

**AC - UNIT MOUNTING**

SCALE : NONE


**1**  
M5.1

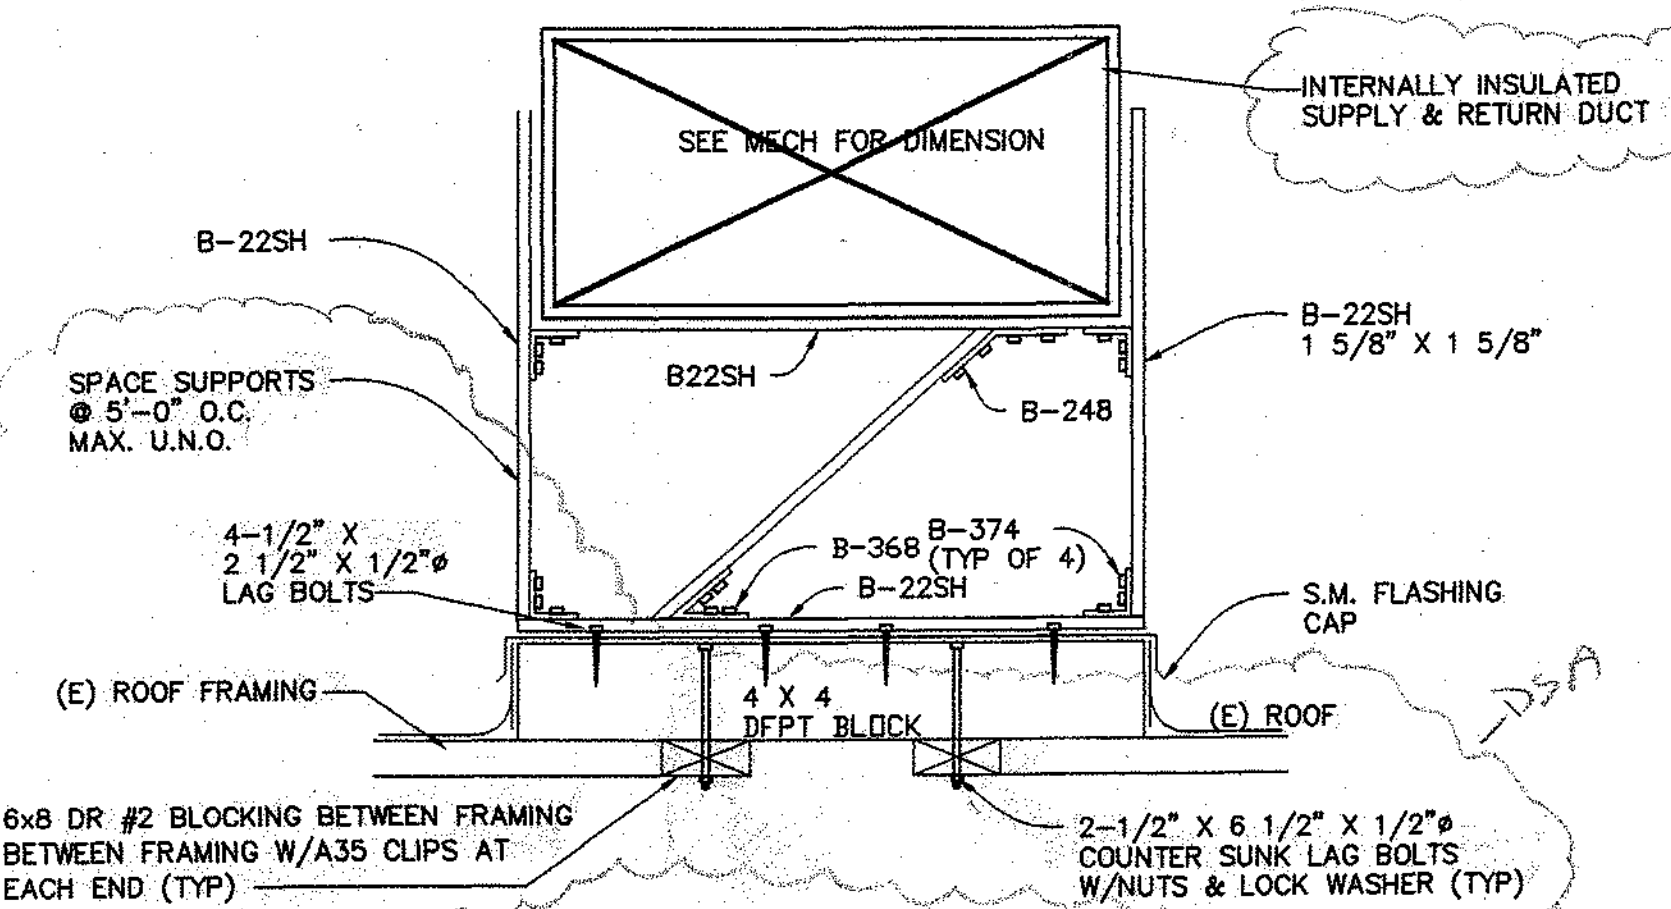

**DUCT SUPPORT ON ROOF DETAIL (B-LINE OR UNISTRUT)**

SCALE : NONE


**9**  
M5.1

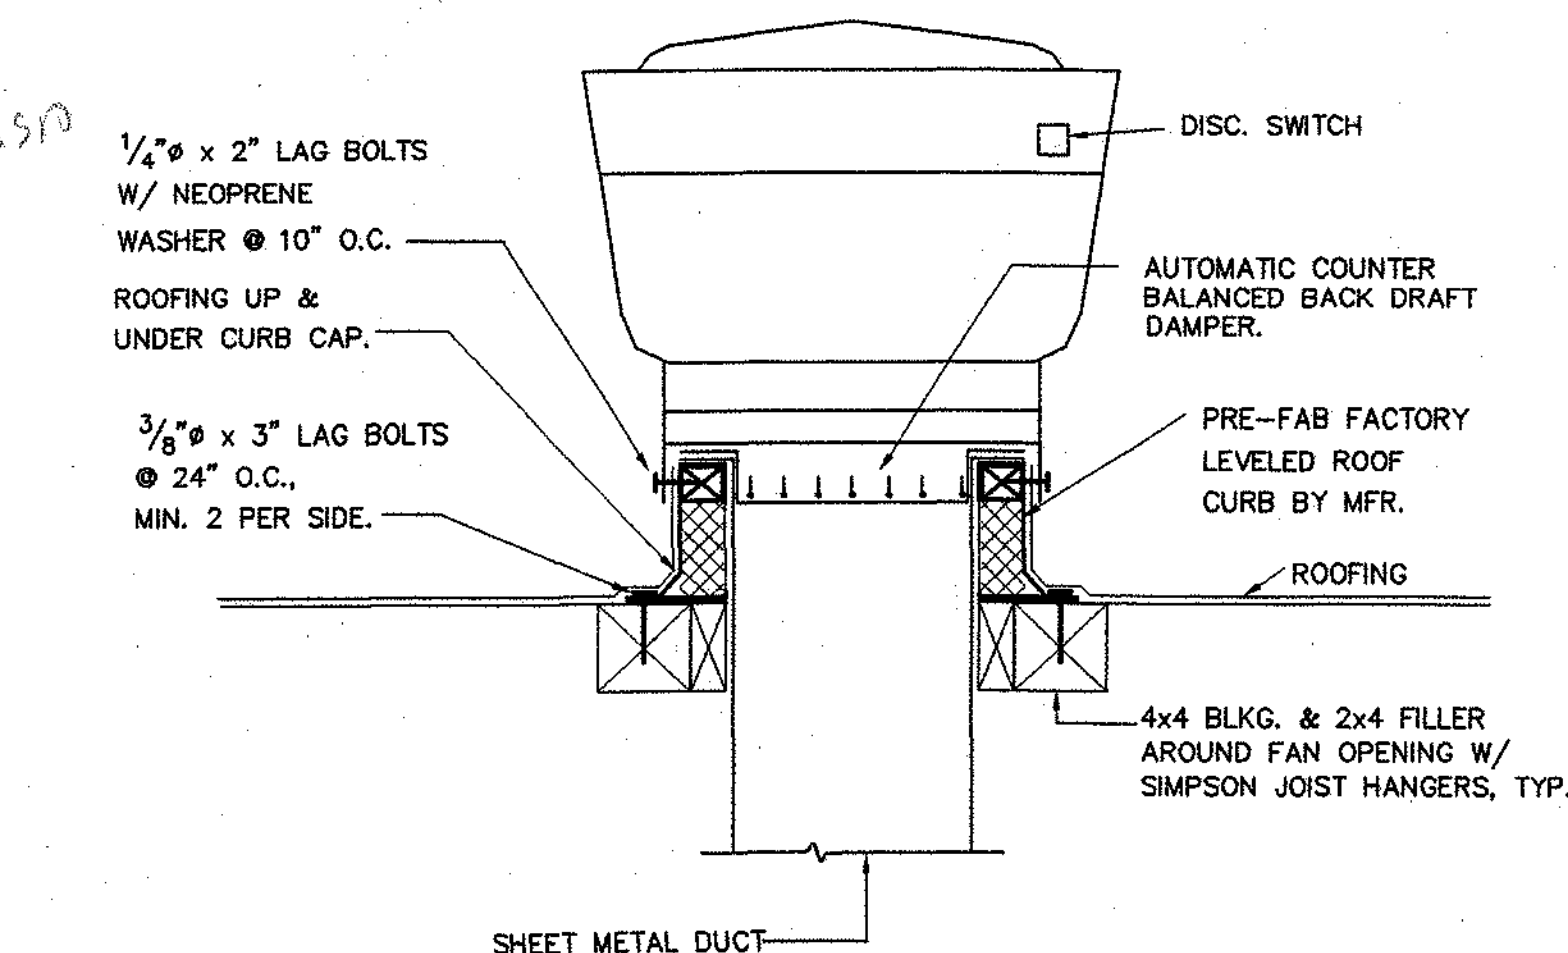

**REF MOUNTING**

SCALE : NONE

**5**  
M5.1

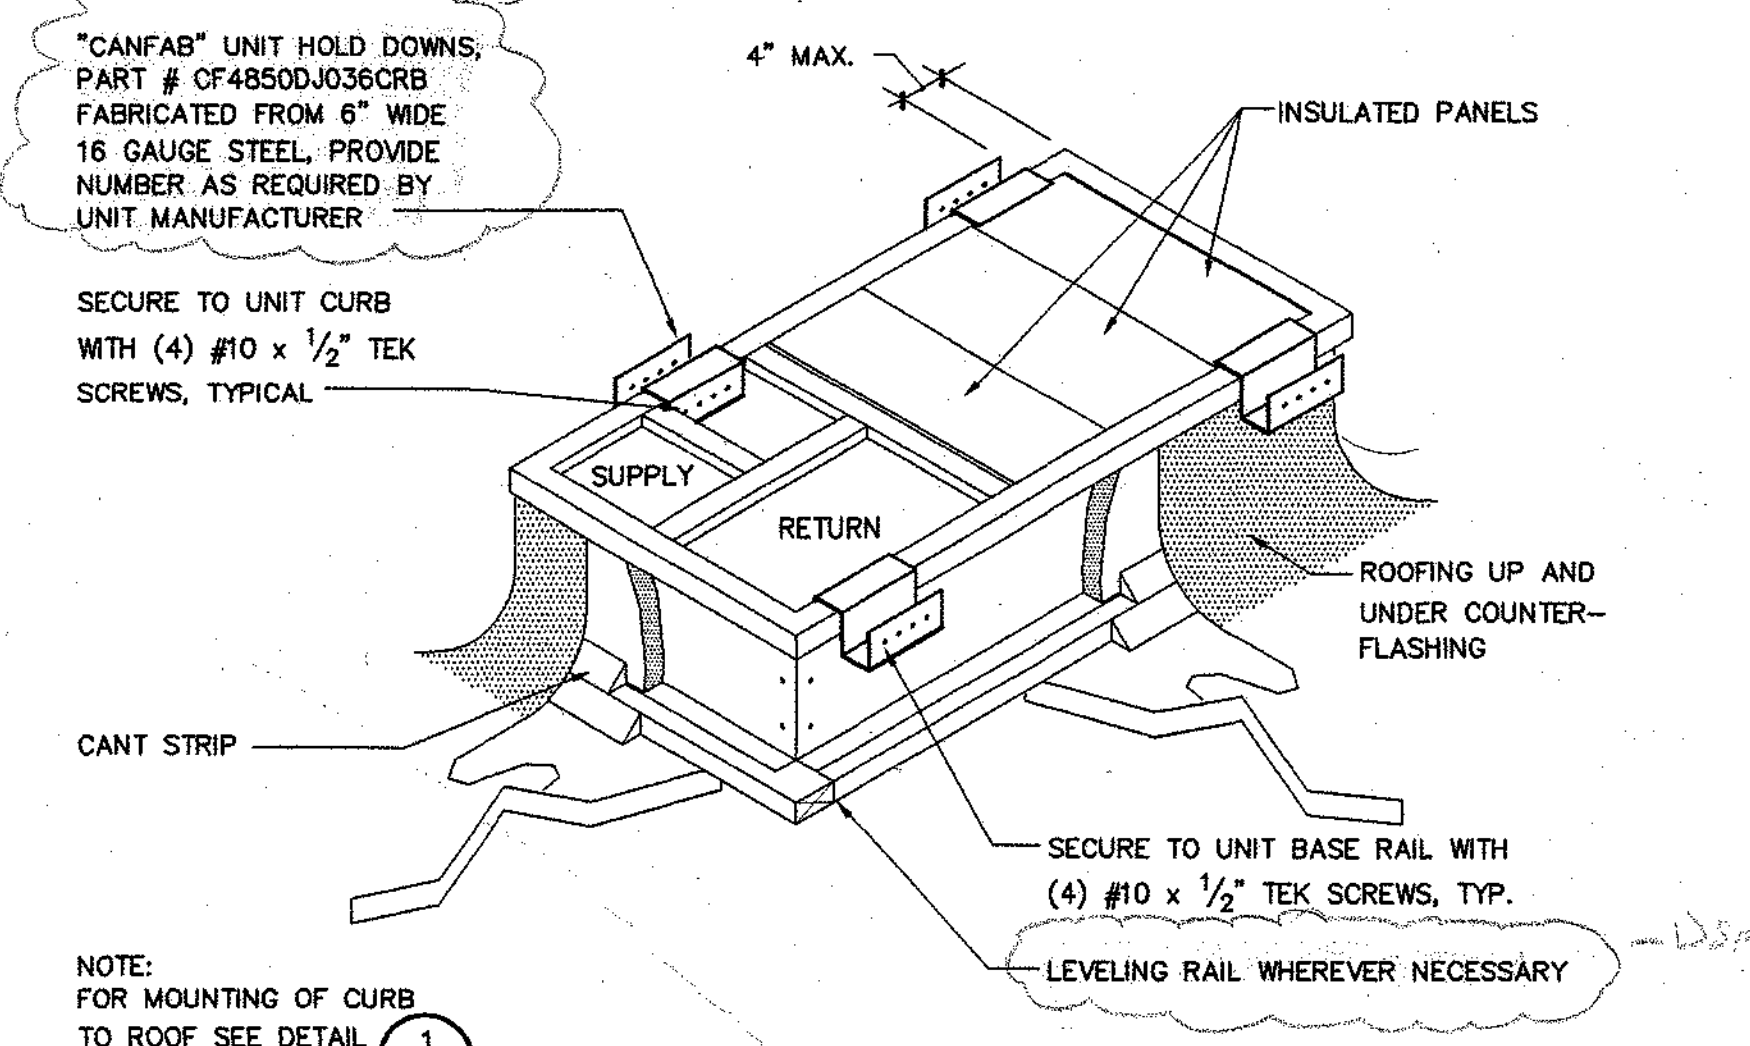

**AC - UNIT "HOLD DOWN"**

SCALE : NONE

**2**  
M5.1


**EQUIPMENT ANCHORAGE**

ALL MECHANICAL AND ELECTRICAL EQUIPMENT SHALL BE BRACED OR ANCHORED TO RESIST A HORIZONTAL FORCE ACTING IN ANY DIRECTION USING THE FOLLOWING CRITERIA AND STATE CHAPTER 16A, VOLUME 2 1998 CALIFORNIA BUILDING CODE:

FIXED EQUIPMENT ON GRADE 20% OF OPERATING WEIGHT  
FIXED EQUIPMENT ON STRUCTURE 34% OF OPERATING WEIGHT

SIMULTANEOUS VERTICAL FORCE - USE 1/3 X HORIZONTAL FORCE.


WHERE ANCHORAGE DETAILS ARE NOT SHOWN ON THE DRAWINGS, THE FIELD INSTALLATION SHALL BE SUBJECT TO THE APPROVAL OF THE STRUCTURAL ENGINEER & DSA.

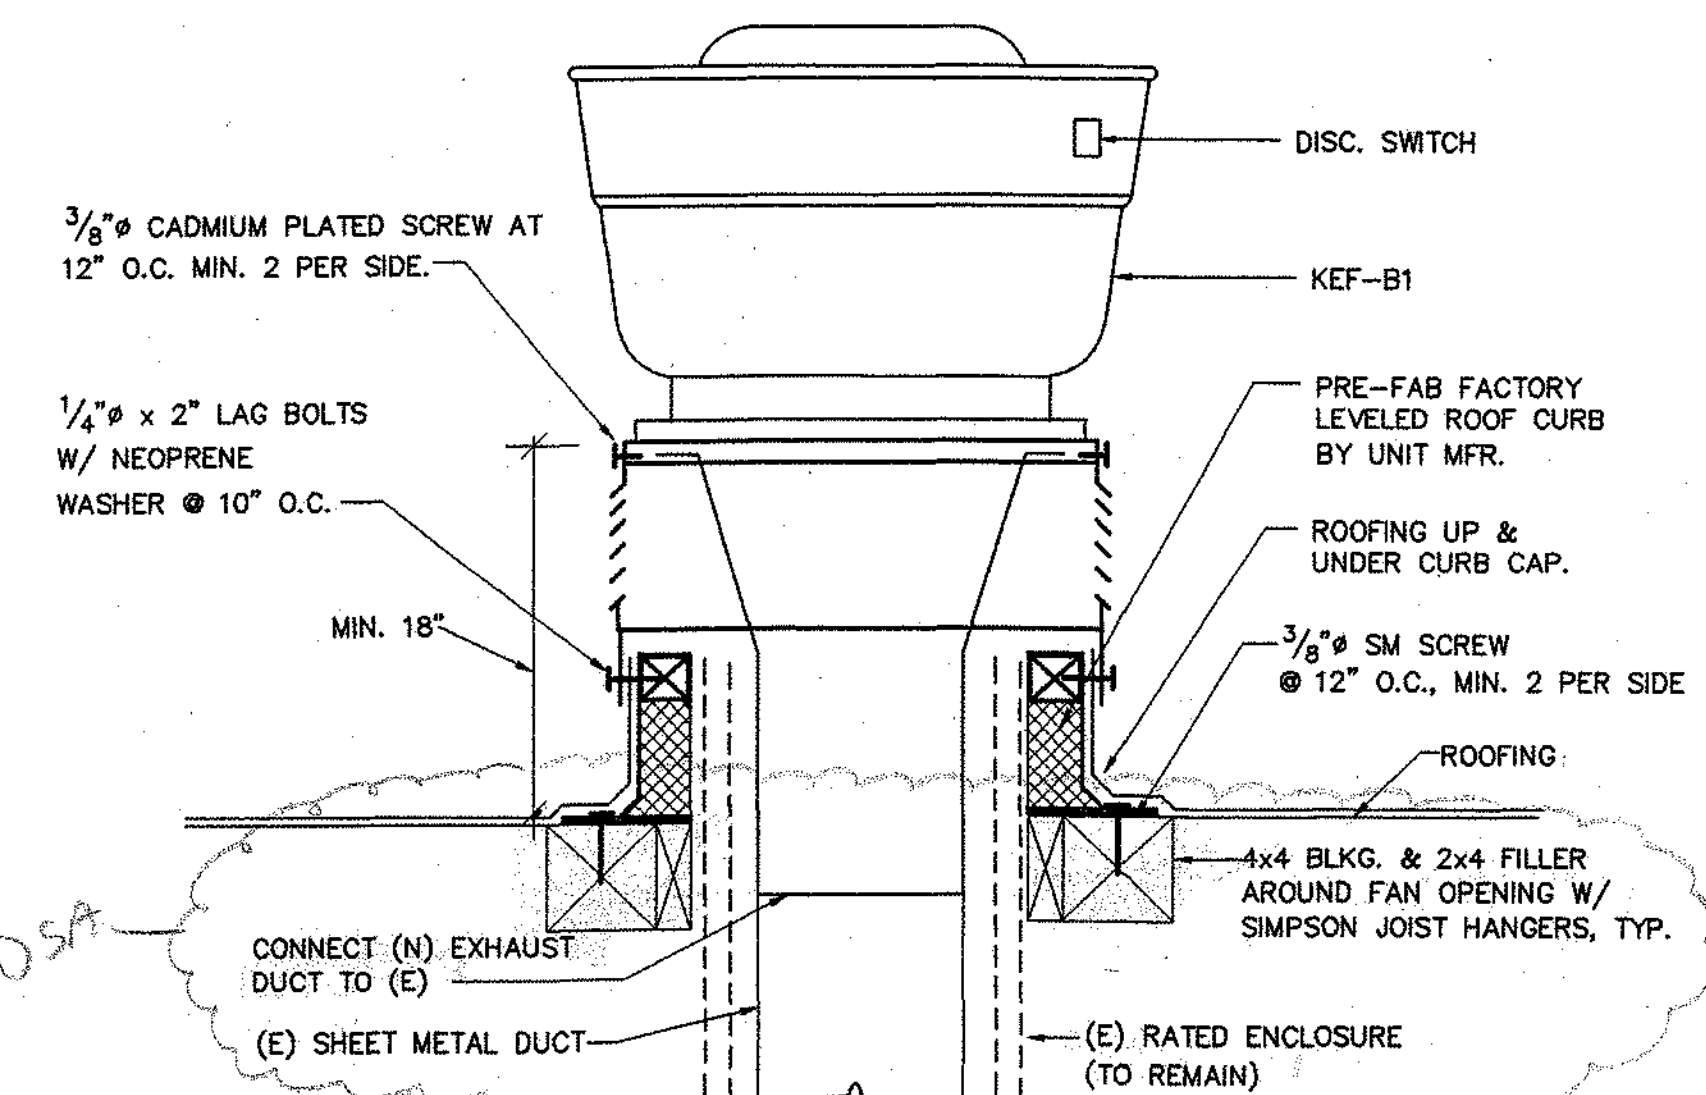

**KEF MOUNTING**

SCALE : NONE

**6**  
M5.1

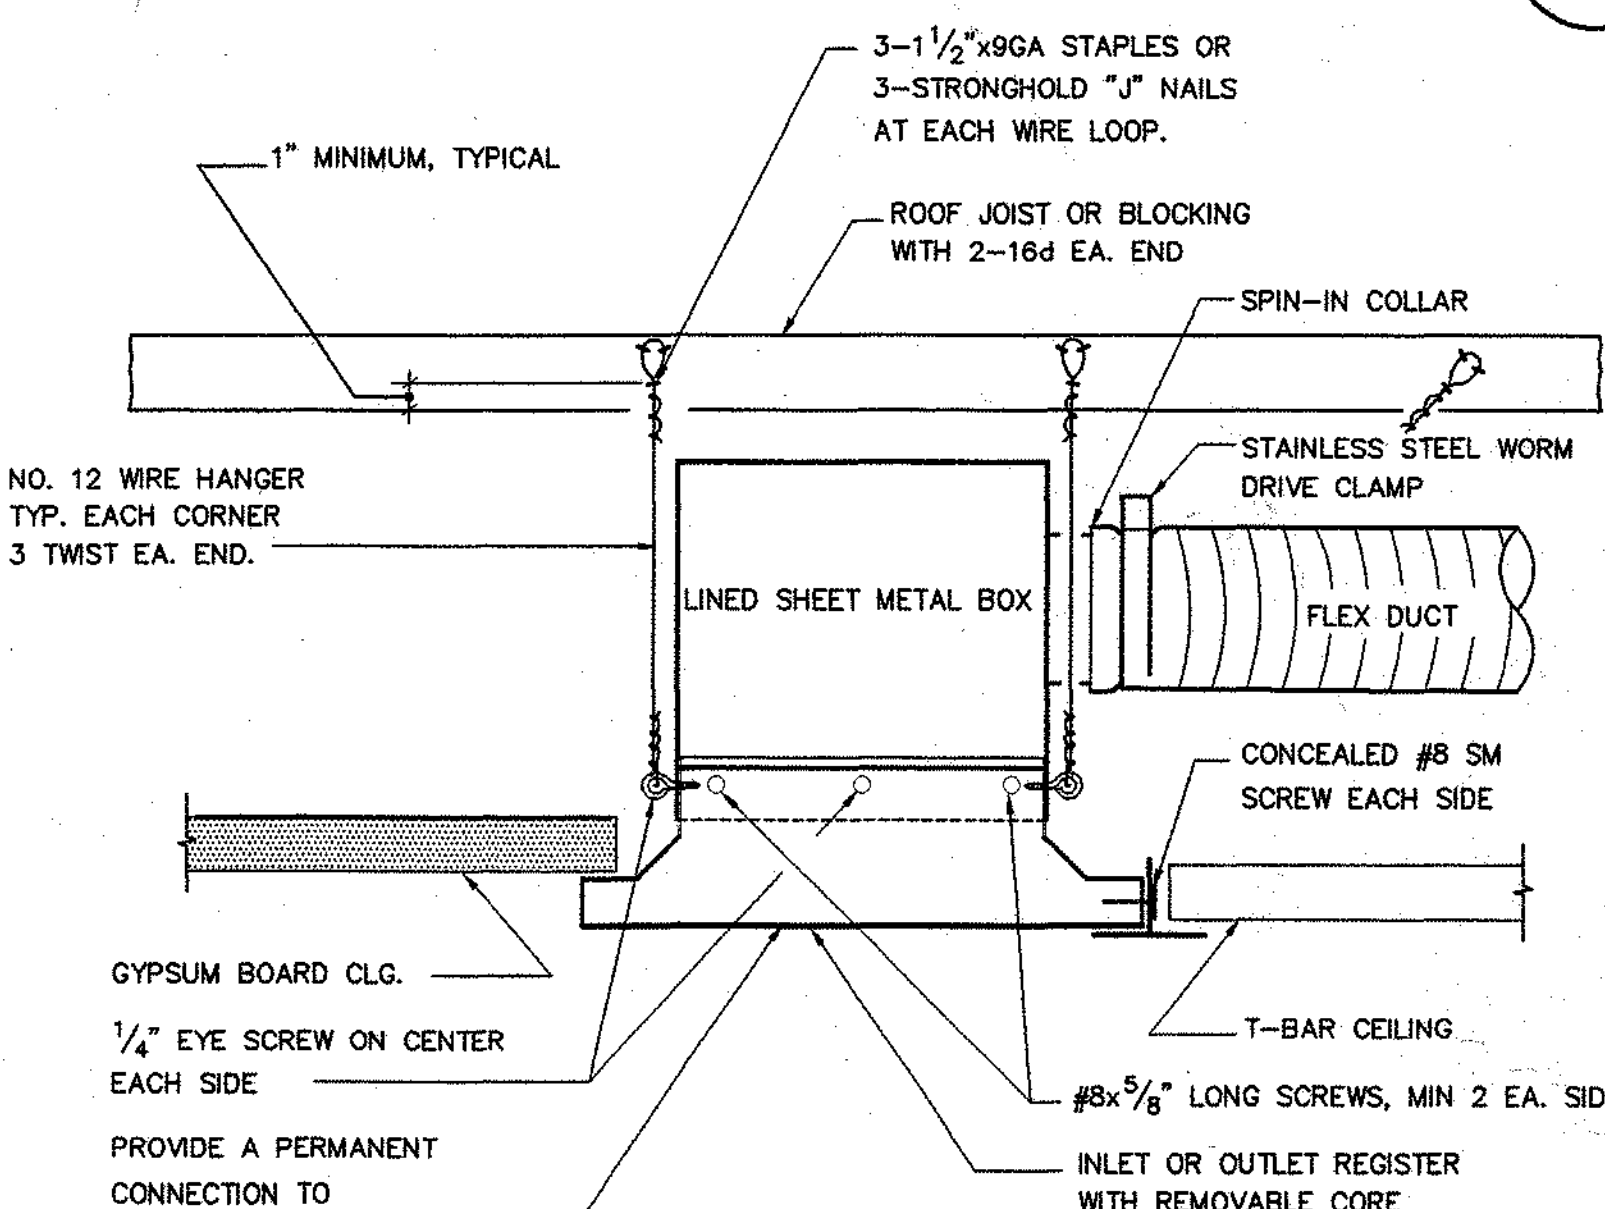

**TYPICAL DIFFUSER/GRILLE MOUNTING**

SCALE : NONE

**3**  
M5.1

**DCA**  
DERIV  
CONSTRUCTION  
ARCHITECTURE

946 North Yosemite Street  
Stockton, California 95203-2217  
P. (209) 462 2873  
F. (209) 462 6308  
E. dca@dcaia.com  
W. http://www.dcaia.com

**Marshall Middle  
School Modernization**  
Stockton Unified School  
District  
Stockton, California

Consultant's Stamp  
Capital Engineering Consultants, Inc.  
RY/YY  
Sheet Title

**HVAC  
DETAILS**

Key Plan

IDENTIFICATION STAMP  
DIV. OF THE STATE ARCHITECT  
02 104030  
AC  
DATE

Job Number

00.445

Drawn By

Date

December 31,01

Sheet Number

**M5.1**


Total Sheets

of


Revisions

DSA Number

Architect's Stamp

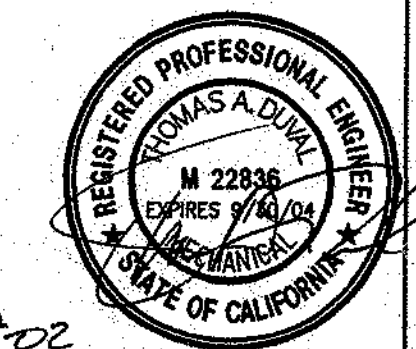


528-02

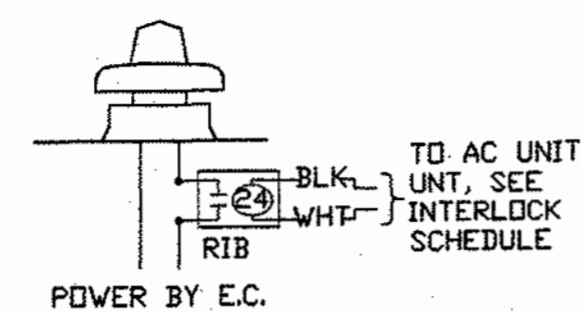


INTERLOCK SCHEDULE

NOTE:  
REFER TO THE AC UNIT SCHEDULES FOR ALL EXHAUST FAN INTERLOCKS

### EXHAUST FAN INTERLOCKS


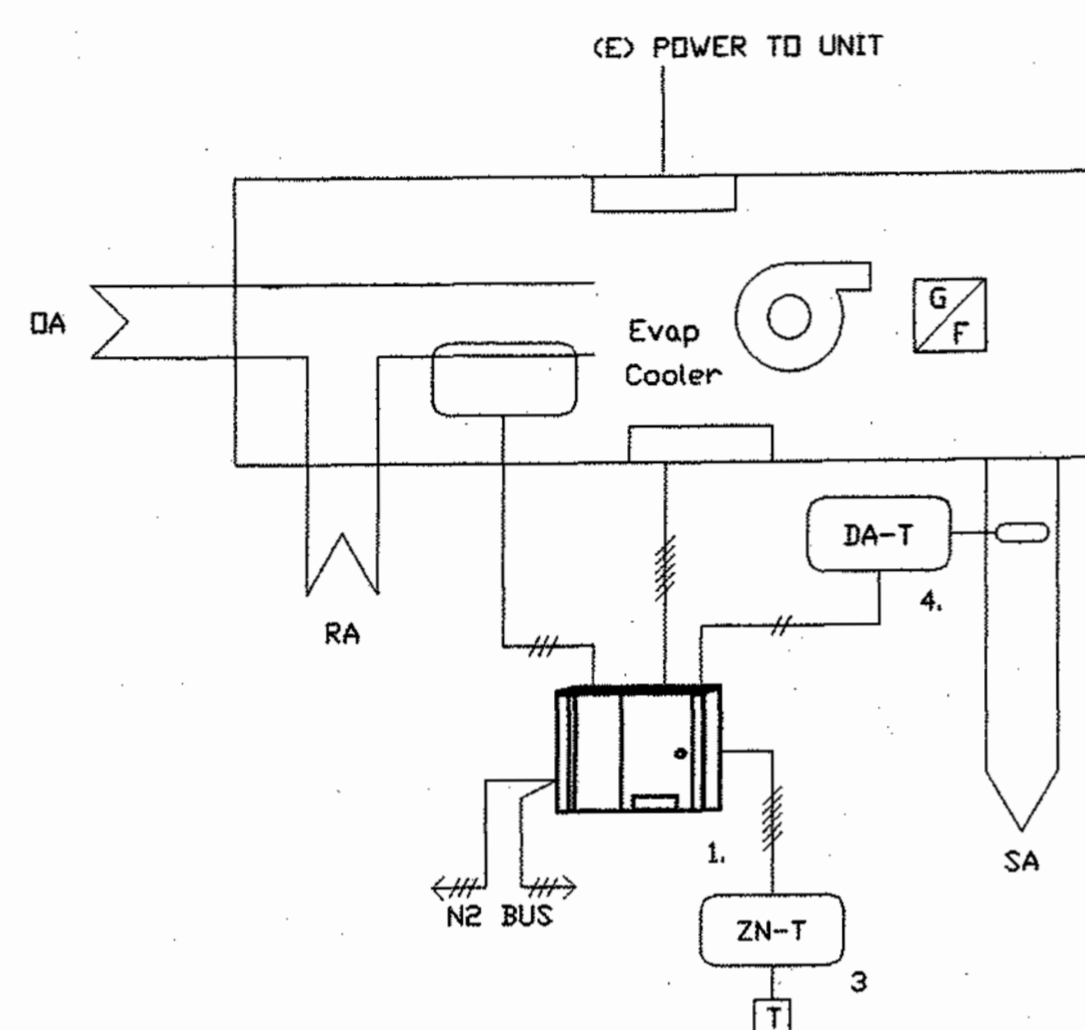


### LOCKER ROOM EXISTING FURNACE - ADD EVAP COOLING

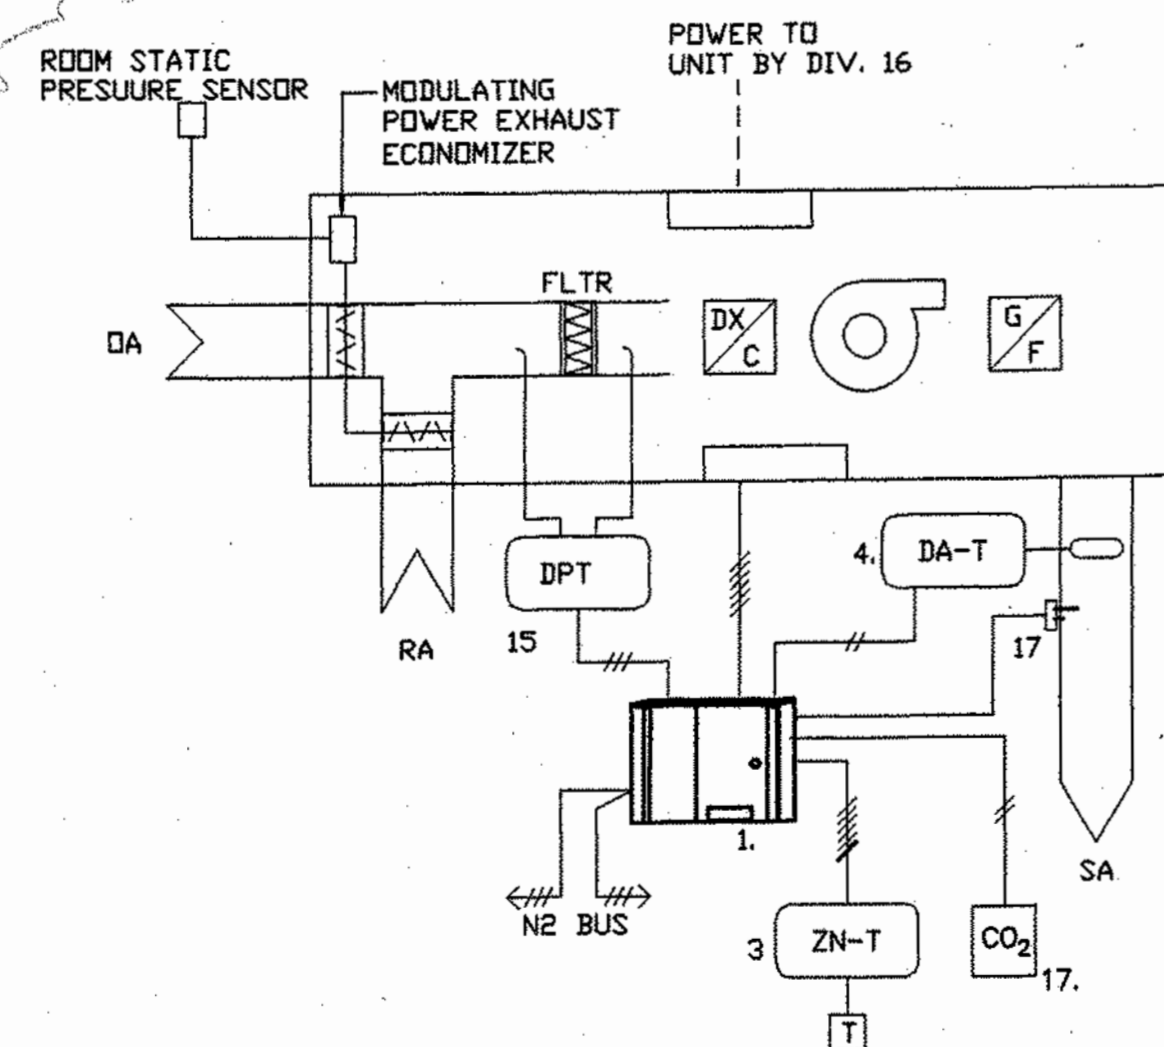


### MULTI-PURPOSE ROOM AC UNITS WITH POWER EXHAUST

NOTE:  
THE MODULATING POWER EXHAUST FAN SPEED SHALL BE CONTROLLED VIA A STATIC PRESSURE SENSOR AND INTEGRAL VFD TO MAINTAIN ZONE STATIC PRESSURE SET POINT BETWEEN 0.00" AND 0.03" W.C.

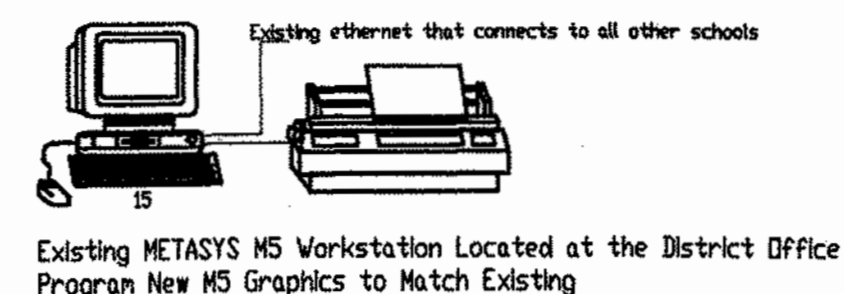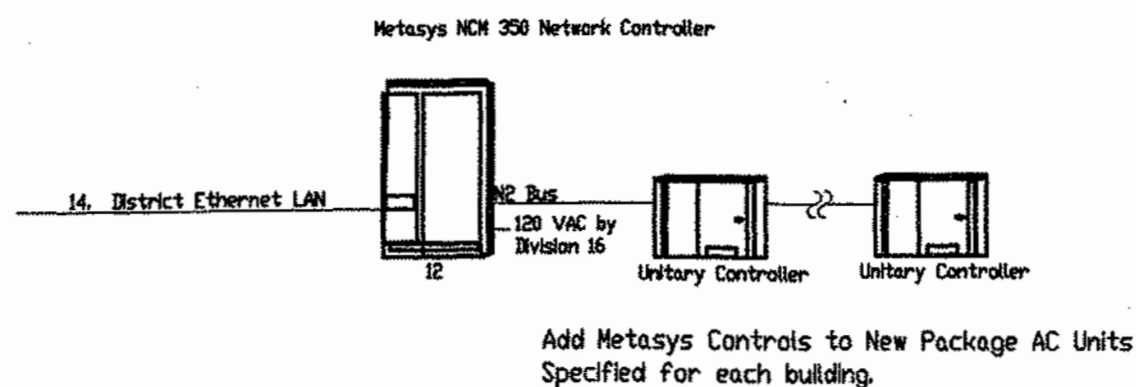

### METASYS SYSTEM ARCHITECTURE

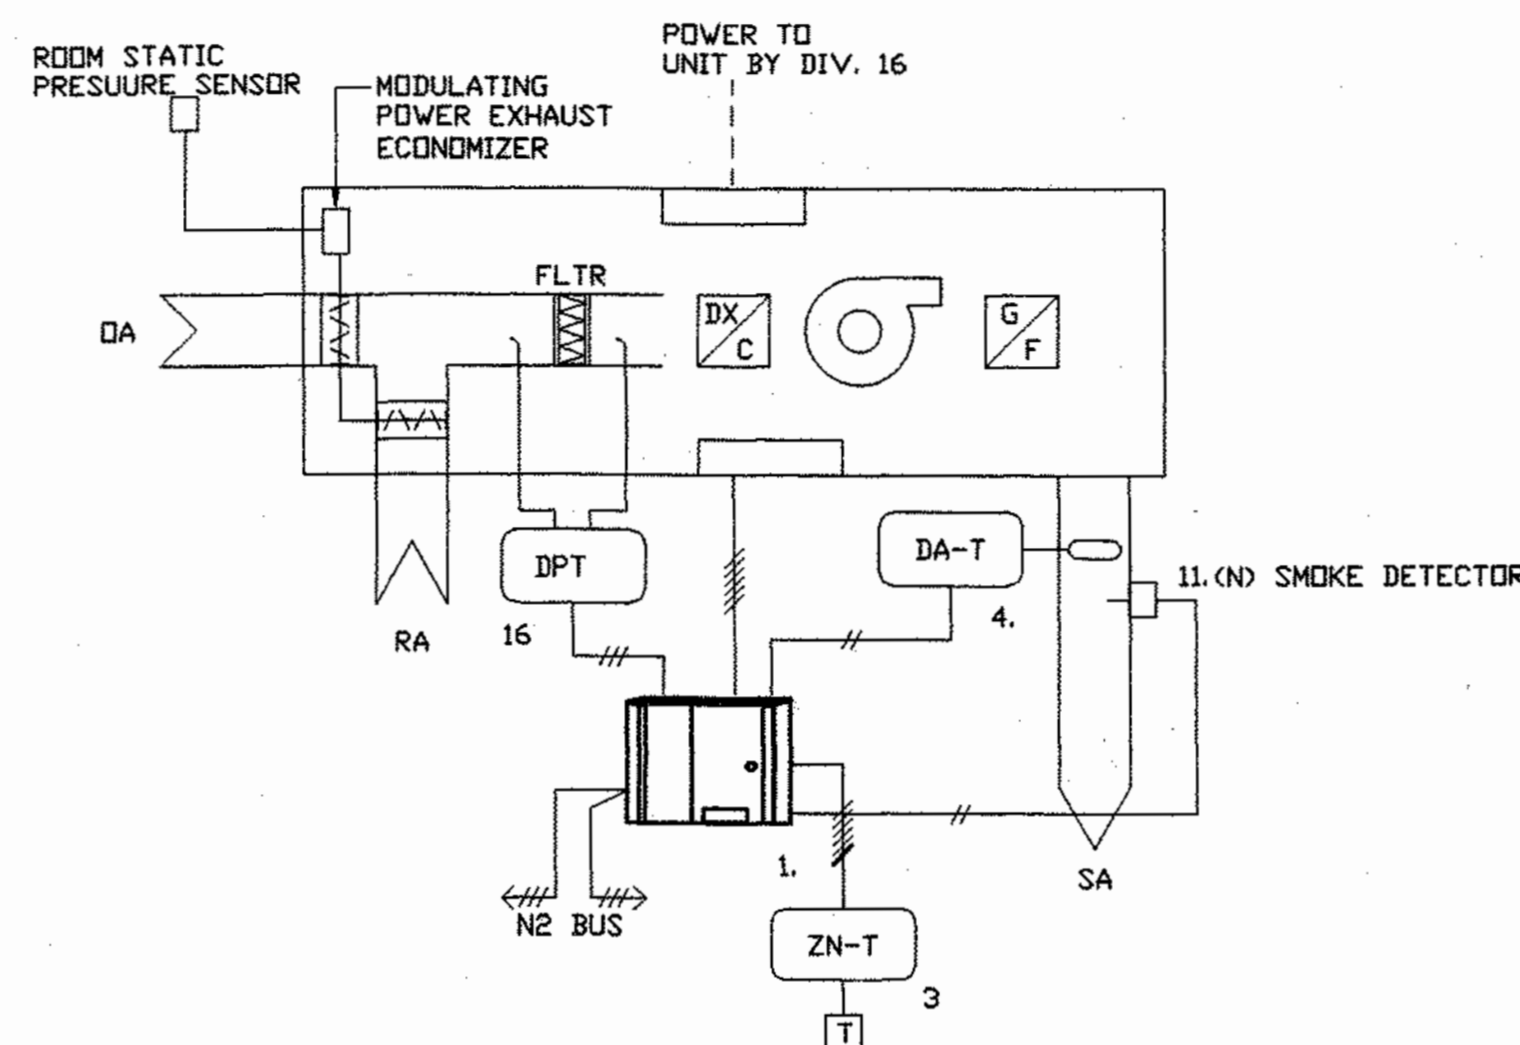

### TYPICAL OF AC UNITS WITH POWER EXHAUST

NOTE:

1. THE MODULATING POWER EXHAUST FAN SPEED SHALL BE CONTROLLED VIA A STATIC PRESSURE SENSOR AND INTEGRAL VFD TO MAINTAIN ZONE STATIC PRESSURE SET POINT OF  $\pm 0.03"$  SP.
2. REFER TO THE AC UNIT SCHEDULES FOR ALL EXHAUST FAN INTERLOCKS
3. REFER TO THE AC UNIT SCHEDULES FOR THE SMOKE INTERLOCKS
4. REFER TO THE AC UNIT SCHEDULES FOR THE CO<sub>2</sub> INTERLOCKS

### DESCRIPTION OF OPERATION

#### GENERAL

THE NEW CONTROLLERS SHALL DIRECTLY INTEGRATE INTO THE EXISTING JOHNSON METASYS ENERGY MANAGEMENT SYSTEM (EMS). IN ADDITION THE NEW CONTROLS WILL FULLY-INTERFACE WITH THE EXISTING METASYS M5 OPERATOR WORKSTATION LOCATED AT THE DISTRICT OFFICE. THE NCM 350 SHALL BE PROGRAMMED TO PROVIDE THE OPERATING SCHEDULES OF EACH UNIT CONTROLLER AS DESIGNATED BY THE SCHOOL DISTRICT. A TITLE 24 COMPLIANT PRE-OCCUPANCY PURGE CYCLE SHALL BE PROGRAMMED INTO THE OPERATION OF EACH HVAC SYSTEM. TIMED TEMPORARY OCCUPANCY OVERRIDE CAN BE ACTIVATED VIA PUSHBUTTON AT EACH THERMOSTAT. THE TEMPERATURE CONTROL CONTRATOR (TCC) SHALL PROVIDE THE FOLLOWING COLORGRAPHIC COMPUTER SCREENS ONTO THE EXISTING EMS COMPUTER AND EXISTING LAPTOP SERVICE TOOL:

- A. SITE PLAN
- B. INDIVIDUAL BUILDING PLAN SHOWING BASIC FLOOR PLAN AND ZONE SENSOR LOCATIONS
- C. EQUIPMENT GRAPHIC DEPICTING ACTUAL EQUIPMENT SHOWING STATUS AND TEMPERATURES.

#### AC PACKAGE UNITS

DURING PERIODS OF OCCUPANCY THE METASYS UNITARY CONTROLLER WILL ENABLE THE FAN AND PROVIDE STAGED HEATING AND COOLING TO MAINTAIN ROOM SETPOINT. EACH AC UNIT WILL HAVE ECONOMIZER CONTROLS THAT WILL POSITION THE ECONOMIZER DAMPERS TO PROVIDE COOLING AS REQUIRED. A FILTER DIFFERENTIAL PRESSURE TRANSDUCER WILL PROVIDE FAN PROOF AND FILTER LOADING MONITORING. WHEN DIFFERENTIAL PRESSURE EXCEEDS SETPOINT (ADJUSTABLE) THE UNIT WILL GO INTO ALARM MODE WHICH CAN BE AUTOMATICALLY DIALED-OUT TO THE DISTRICT WORKSTATION. PROVIDE SUPPLY AIR SMOKE DETECTOR FOR ALL UNITS LISTED TO SHUT-DOWN AC UNIT UPON DETECTION OF SMOKE.

#### KITCHEN EXHAUST FAN INTERLOCKS

INTERLOCK THE KITCHEN EXHAUST FANS TO AC 4 REFER TO THE MECHANICAL DRAWING FOR DETAILS

#### ALARMS

THE FOLLOWING ALARMS SHALL BE SET AT THE NCM 350 AND SENT OVER ETHERNET TO THE SCHOOL DISTRICT CENTRAL M5 METASYS WORKSTATION:

1. DIRTY FILTER (1.0-IN. WG.)
2. SUPPLY FAN FAILURE
3. HEATING FAILURE
4. COOLING FAILURE
5. ZONE HIGH TEMPERATURE (5 DEGF HIGHER THAN SETPOINT FOR 15 MINUTES)
6. ZONE LOW TEMPERATURE (5 DEGF LOWER THAN SETPOINT FOR 15 MINUTES)

#### CONTROL NOTES:

1. ONE GLOBAL OUTSIDE AIR TEMPERATURE SENSOR FOR THE CAMPUS REQUIRED.
2. SMOKE DETECTORS SHALL BE FACTORY SUPPLIED, INSTALLED, WIRED, AND POWERED BY UNIT MANUFACTURER
3. ADDITIONAL COMPONENTS TO COMPLETE DESIGN INTENT ARE THE RESPONSIBILITY OF THE CONTROL CONTRACTOR.
4. CONNECT THE NCM 350 CONTROLLER TO THE DISTRICT ETHERNET

#### CONTROL MATERIAL LEGEND

1. METASYS CONTROLLER (AS-UNT141-1)  
TYPICAL FOR ALL NEW AND EXISTING HVAC SYSTEMS
2. GLOBAL OUTSIDE AIR TEMPERATURE SENSOR (TE-6313P-1)
3. ZONE TEMPERATURE SENSOR (TE-6411W-1110)
4. HOT DECK, COLD DECK AND RETURN AIR TEMPERATURE SENSOR (TE-6311P-1)
5. MIXED AIR AVERAGING ELEMENT TEMPERATURE SENSOR (TE-6315P-1)
6. CURRENT SENSING RELAY (VERIS H-900)
7. DIFFERENTIAL PRESSURE SWITCH (P32AF-2C)
8. CONTROL RELAY (IDEC RH2B WITH LED)
9. PROPORTIONAL DAMPER ACTUATOR (M9216-HGA-2)
10. PROPORTIONAL DAMPER ACTUATOR (M9108-GGA-2)
11. SMOKE DETECTOR (SYSTEM SENSOR DH100ACDCP AND SENSING TUBES (ST).
12. METASYS NCM 350 CONTROLLER WITH ETHERNET CARD (NCM-350-8 NETWORK CONTROLLER WITH 8 MEG OF MEMORY)
13. VT-100 TERMINAL (WYSE)
14. CONNECT THIS SCHOOL USING THE EXISTING DISTRICT ETHERNET
15. EXISTING DISTRICT WORKSTATION TO BE UPGRADED BY THE CONTROL CONTRACTOR TO ALLOW COMMUNICATION WITH THE NEW NCM 350 CONTROLLER.
16. DPT DIFFERENTIAL PRESSURE TRANSDUCER 0-1.5" WC JOHNSON DPT-2015
17. CO<sub>2</sub> SENSOR.

### GENERAL NOTES

- 1 - CONTROL WIRING SHALL BE IN CONDUIT.
- 2 - CONCEALED CONTROL WIRING WILL BE RUN EXPOSED USING #18 - PLENIUM RATED CABLE

WIRING BY DIV. 15

WIRING BY DIV. 16




946 North Yosemite Street  
Stockton, California 95203-2217

P. (209) 462 2873  
F. (209) 462 8300  
E. dca@dcaia.com  
W. http://www.dcaia.com

**Marshall Middle  
School Modernization**  
Stockton Unified School  
District  
Stockton, California


Consultant's Stamp

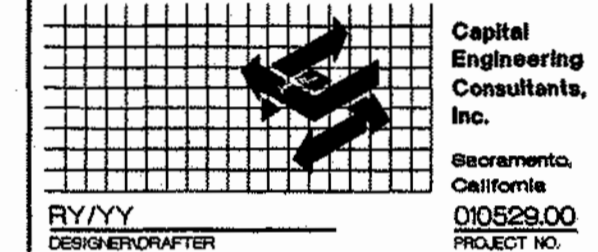

Sheet Title

### CONTROLS

Key Plan

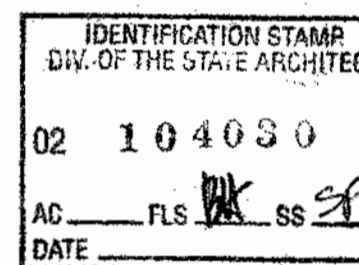

Job Number

00.445

Drawn By

Date

December 31, 01

Sheet Number

M6.1

Total Sheets

of

Revisions

DSA Number

Architect's Stamp

5-2802